


ALBERTA LAND SURVEYOR'S REAL PROPERTY REPORT

The City of Calgary Planning and Development
CERTIFICATE OF COMPLIANCE
 Provided that all of the information shown on this survey plan is accurate the location of the building as shown complies with the Calgary Land Use Bylaw 1P2007. This Certificate of Compliance relates only to the building location requirements of the Land Use Bylaw 1P2007 and does not relate to the requirements of any federal, provincial or other municipal legislation nor to the terms and conditions of any easement, covenant, building scheme agreement or other document affecting the building or land.
 Date: May 31, 2018

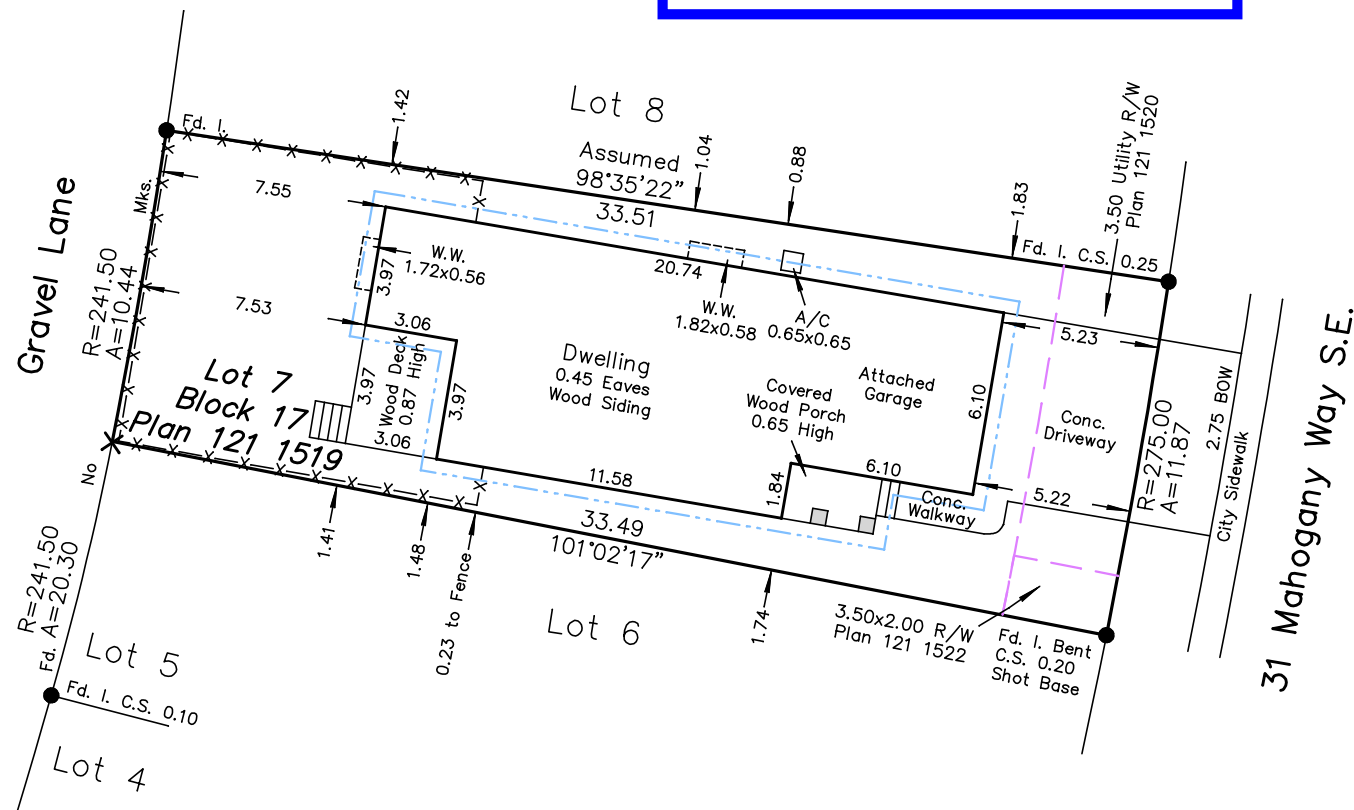

- ABBREVIATIONS**
- A---Arc Length
 - Acc.---Accessory
 - A/C---Air Conditioner
 - Bldg---Building
 - BOC---Back of Curb
 - BOW---Back of Walk
 - Calc.---Calculated
 - Cant.---Cantilever
 - Conc.---Concrete
 - C.S.---Countersunk
 - DH---Drill Hole
 - Enc.---Encroaches
 - Fd.---Found
 - I.---Iron Post
 - I.B.---Iron Bar
 - M.A.---Maintenance Access
 - Mk.---Mark
 - O.D.---Overland Drainage
 - R---Radius
 - Reg.---Registration
 - Ret.---Retaining
 - R/W---Right of Way
 - W/O---Walkout Basement
 - W.W.---Window Well

NOTE:
 UNLESS NOTED OTHERWISE LINES OUTSIDE OF PROPERTY ARE NOT TO SCALE.

LEGAL DESCRIPTION:

Lot 7
 Block 17
 Plan 121 1519

MUNICIPAL ADDRESS:

31 Mahogany Way S.E.
 Calgary, Alberta

DATE OF SURVEY: May 31st, 2018.

LEGEND

Distances are in metres and decimals thereof.

- Found Iron Posts are shown thus: ●
- Drill Holes are shown thus: ⊗
- Found Iron Bars are shown thus: ◆
- Found Concrete Nails are shown thus: ▲
- Calculation points are shown thus: X
- Pillars and posts are shown thus: □
- Property lines are shown thus: ———
- Utility Right of Ways are shown thus: ———
- Eaves are shown thus: ———
- Fences are shown thus: —x—x—

All fences are within 0.2 metres of the property lines unless otherwise shown.
 All eaves are measured to fascia unless otherwise shown.

PURPOSE:

This Report and attached plan have been prepared for the benefit of the Property owner, subsequent owners and any of their agents for the purpose of a land conveyance, support of a subdivision application, a mortgage application, or a submittal to the municipality for the compliance certificate, etc. Copying is permitted only for the benefit of these parties, and only if the plan remains attached. Where applicable, registered easements and utility rights of way affecting the extent of the property have been shown on the attached plan. Unless shown otherwise, property corner markers have not been placed. The attached plan should not be used to establish boundaries due to the risk of misinterpretation or measurement error by the user. The information shown on this Real Property Report reflects the status of this property as of the date of survey only. Users are encouraged to have the Real Property Report updated for future requirements.

NOTE:

Title information is based on the C. of T. 131 246 997 which was searched on the 31st day of May, 2018, and is subject to:
 Utility Right of Way No.: 121 128 472
 Restrictive Covenant No.: 121 128 474
 Easement No.: 121 128 475
 Encumbrance No.: 121 128 476

CERTIFICATION:

I hereby certify that this report, which includes the attached plan and related survey, was prepared and performed under my personal supervision and in accordance with the Alberta Land Surveyors' Association Manual of Standard Practice and supplements thereto. Accordingly within those standards and as of the date of this Report, I am of the opinion that:

- the Plan illustrates the boundaries of the Property, the improvements as defined in Part D, Section 8.5 of the Alberta Land Surveyors' Association's Manual of Standard Practice, registered easements, and rights-of-way affecting the extent of the title to the property;
- the improvements are entirely within the boundaries of the Property
- no visible encroachments exist on the Property from any improvements situated on an adjoining property
- no visible encroachments exist on registered easements or rights-of-way affecting the extent of the Property
- unless otherwise specified, the dimensions shown relate to the distances from property boundaries to the foundation walls of buildings at the date of survey.

Dated at Calgary, Alberta on this
 31st day of May, 2018.

Rheel Bourgouin, A.L.S.
 This document is not valid unless it bears
 an original or digital signature in blue ink and
 an Arc Surveys Ltd. permit stamp in red ink.



© Copyright Arc Surveys Ltd. 2018

Arc Surveys Ltd.

201B 38th Avenue NE, Calgary, AB T2E 2M3
 Ph.: 403-277-1272 www.arcsurveys.ca
 Fax: 403-277-1275 info@arcsurveys.ca

Surveyed: SC Drawn: YY Scale: 1:250 File No.: 181379